






1 PERSPECTIVE
AR 01 SCALE: N T S

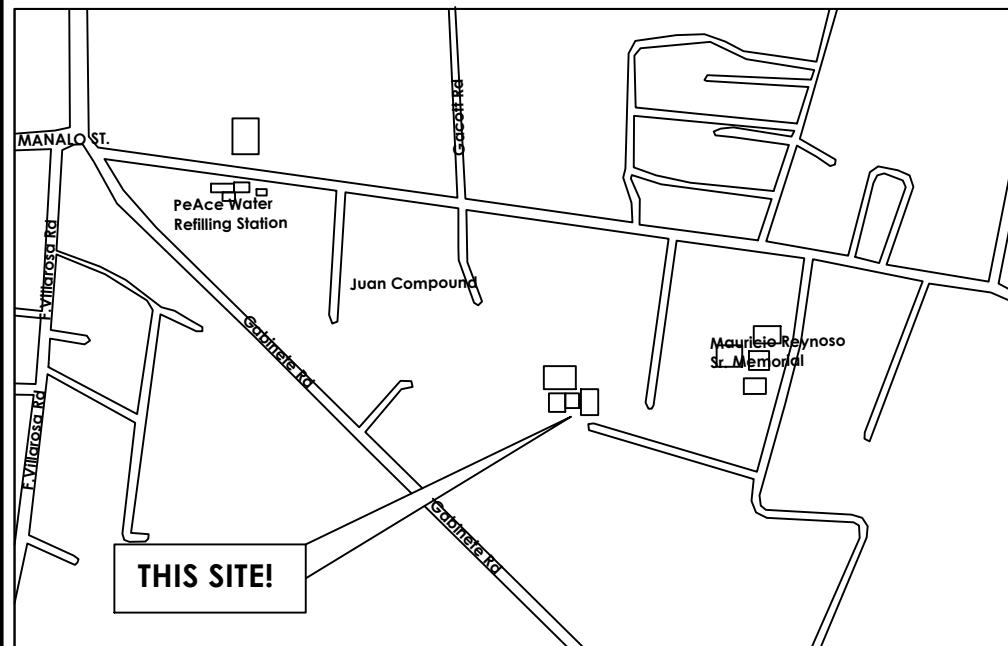

2 VICINITY MAP
AR 01 SCALE: N T S

LOT DESCRIPTION		
	BEARING	LENGTH(m)
1-2	N 66DEG. 07'E	12.03M
2-3	S 08DEG. 11'E	23.52M
3-4	S 28DEG. 54' E	18.62M
4-5	S 76DEG. 19' W	16.80M
5-6	N 10DEG. 18' W	39.31M

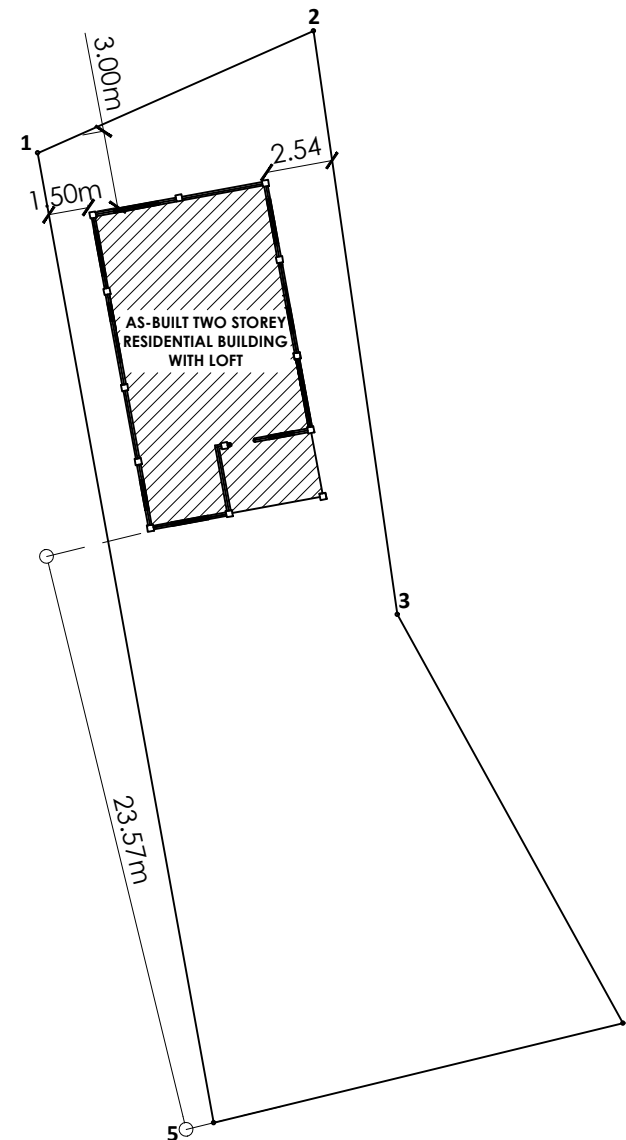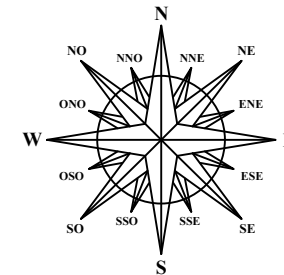

3 SITE DEVELOPMENT PLAN
AR 01 SCALE: 1:300MTS

TABLE OF CONTENTS

AR-1 ARCHITECTURAL

TABLE OF CONTENTS
PERSPECTIVE VIEW
VICINITY MAP
SITE DEVELOPMENT PLAN

AR-2 ARCHITECTURAL

GROUND FLOOR PLAN
SECOND FLOOR PLAN

AR-3 ARCHITECTURAL

FRONT ELEVATION
REAR ELEVATION
LEFT ELEVATION
RIGHT ELEVATION

AR-4 ARCHITECTURAL

REFLECTED CEILING PLAN
ROOF PLAN

AR-5 ARCHITECTURAL

SCHED. OF DOORS & WINDOWS
CROSS SECTION
LONGITUDINAL SECTION

AR-6 ARCHITECTURAL

STAIRS DETAILS FOUNDATION PLAN
RAILINGS DETAILS

ST-1 STRUCTURAL

FOUNDATION PLAN
ROOF FRAMING PLAN

ST-2 STRUCTURAL

C1/F1 DETAILS
WALL FOOTING DETAILS
SCHED OF BEAMS, COLUMN, AND FOOTING

ST-3 STRUCTURAL

SCHEDULE OF BEAMS, COLUMNS AND FOOTING

ST-3 STRUCTURAL

CONSTRUCTION NOTES
STAIRS DETAILS

EL-1 ELECTRICAL

LIGHTING LAYOUT
POWER LAYOUT
PANEL BOARD DIAGRAM
LOAD SCHEDULE

EL-2 ELECTRICAL

LOAD COMPUTATION
GENERAL NOTEES
ELECTRICAL SYMBOLS

PL-1 PLUMBING

STORM DRAINAGE LAYOUT
ISO-STORM DRAINAGE LAYOUT

REPUBLIC OF THE PHILIPPINES
CITY ENGINEERING OFFICE

OFFICE OF THE BUILDING OFFICIAL
PUERTO PRINCESA CITY, PALAWAN

RECOMMENDING APPROVAL:

LAND USE AND ZONING

RECOMMENDING APPROVAL:

LINE AND GRADE

RECOMMENDING APPROVAL:

ARCHITECTURAL

RECOMMENDING APPROVAL:

STRUCTURAL

RECOMMENDING APPROVAL:

SANITARY

RECOMMENDING APPROVAL:

ELECTRICAL

RECOMMENDING APPROVAL:

MECHANICAL

ENGINEER:

REG. NO. 016350

PROJECT TITLE / LOCATION :

OWNER :

SHEET CONTENTS :

DRAWN BY :

SHEET NO :



DANIEL D. PALANCA JR.

CIVIL ENGINEER

T. I. N.

PTR NO. 1915929

DATE ISSUE 01/11/24

PLACE ISSUE P.P.C

AS-BUILT TWO STOREY RESIDENTIAL BUILDING WITH LOFT

BRGY. BANCAO-BANCAO, PUERTO PRINCESA CITY, PALAWAN

MARY ANDREA LYN G. VANDEWEGHE

BRGY. BANCAO-BANCAO, P.P.C, PALAWAN

AS SHOWN

DESIGNED BY :

DATE :

REVISED BY :

DATE :

A
1