




# AS BUILT DRAWING AND LASER SCANNING



WHEN DETAILS MATTER!

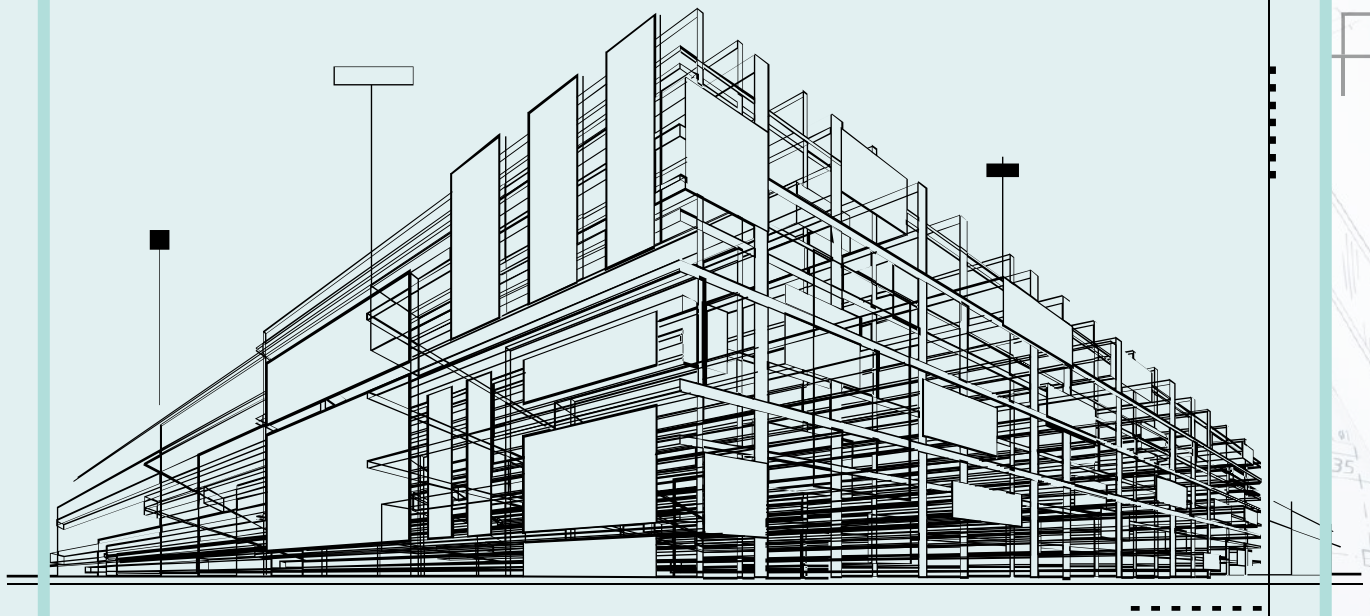

(236) 988-8488



measurebuilt.com



info@measurebuilt.com


- Floor plans done with an accuracy ensures all dimensions are correct, reducing costly design errors and rework. Every element is clearly labeled for easy interpretation.

# EXTERIOR ELEVATIONS

- Detailed and city-permit-ready, capturing materials, dimensions, and architectural features with precision




② SOUTH ELEVATION  
SCALE: 1/4"=1'-0"

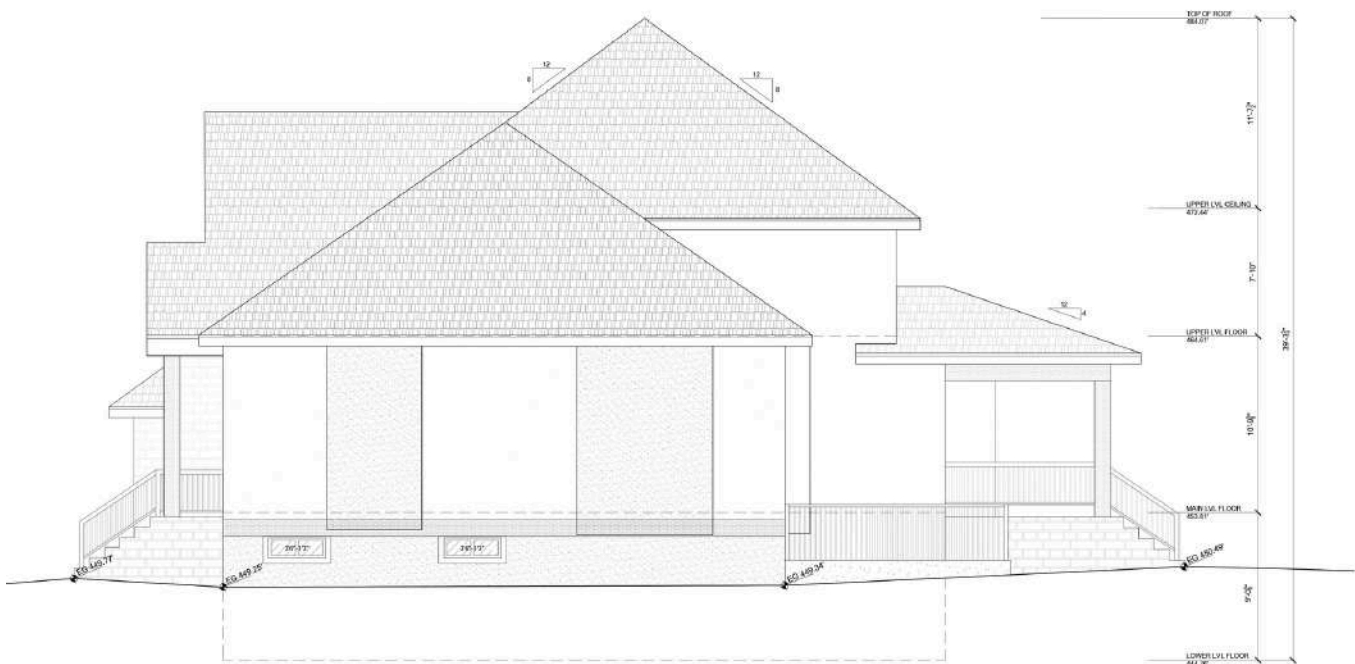

③ EAST ELEVATION  
SCALE: 1/4"=1'-0"

# RCP (Reflected Ceiling Plan)

- Highly detailed, showing all ceiling elements, including lighting, HVAC, and plumbing, ensuring seamless coordination with contractors.

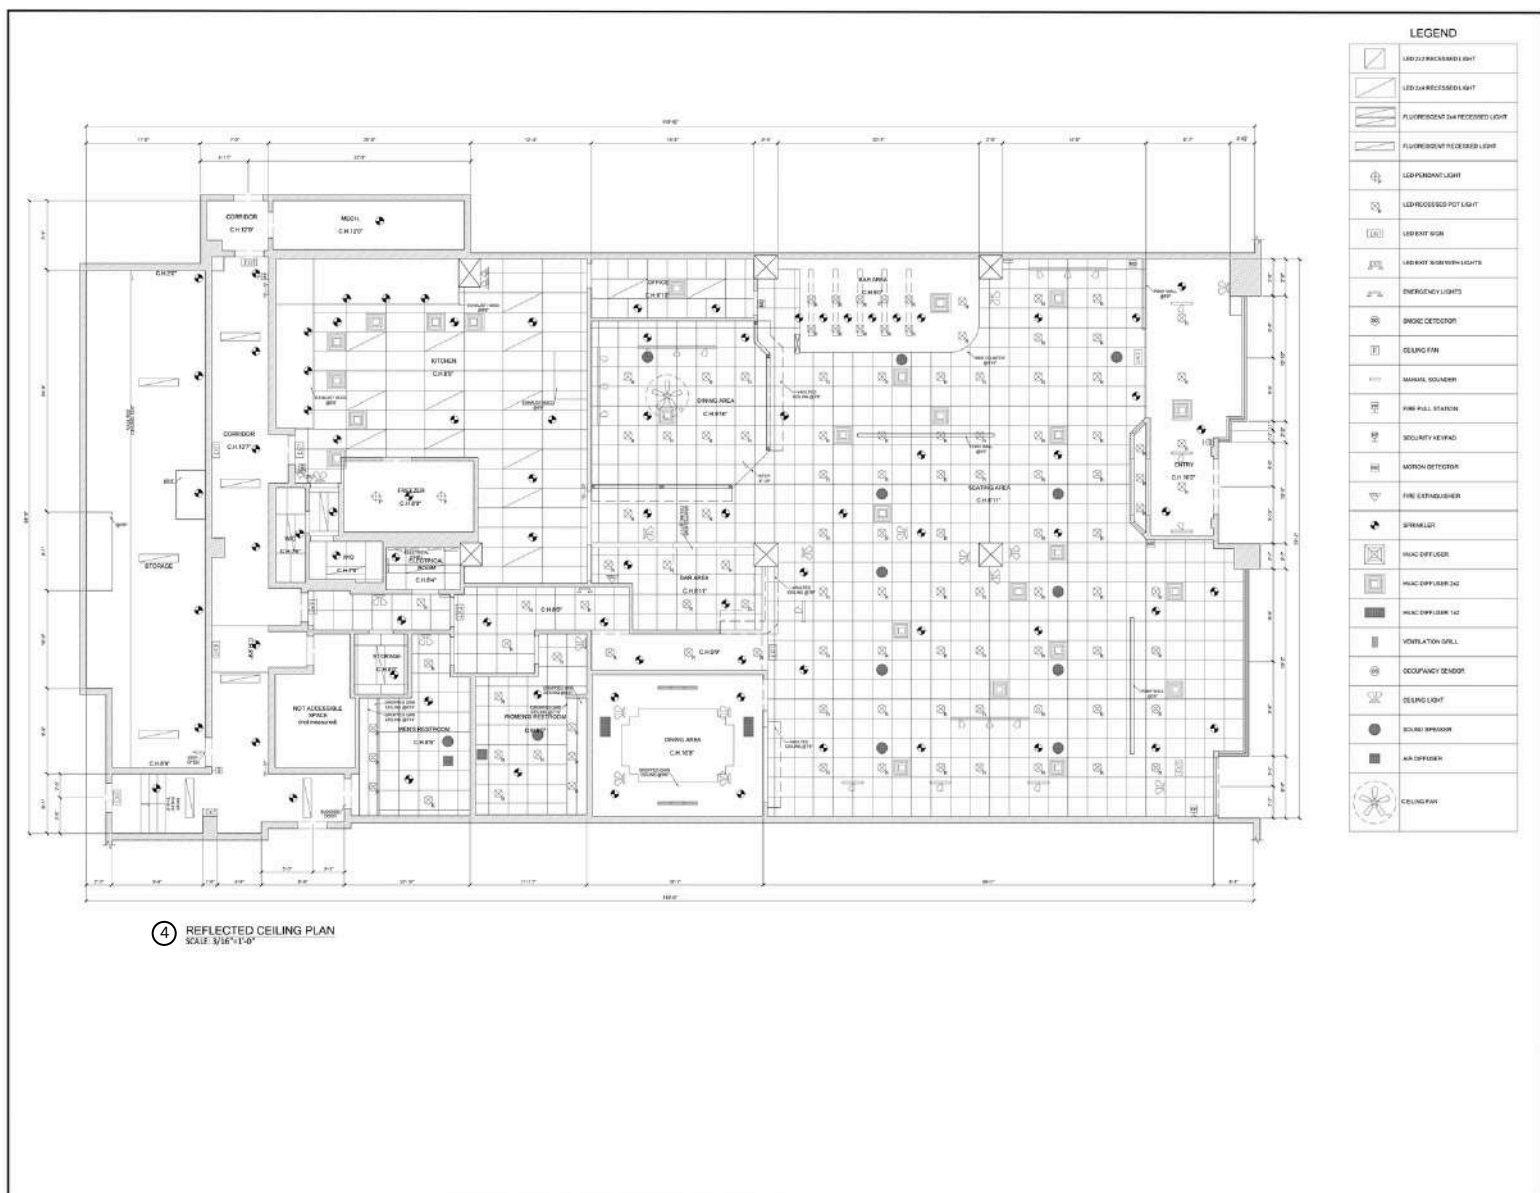


\*\* Detailed, true-to-scale plans with laser scanning

# SITE PLANS

(ADDS ON)

- A precise overview of the property, including building footprint, lot boundaries, parking, and landscaping, ensuring compliance with zoning and permit requirements.

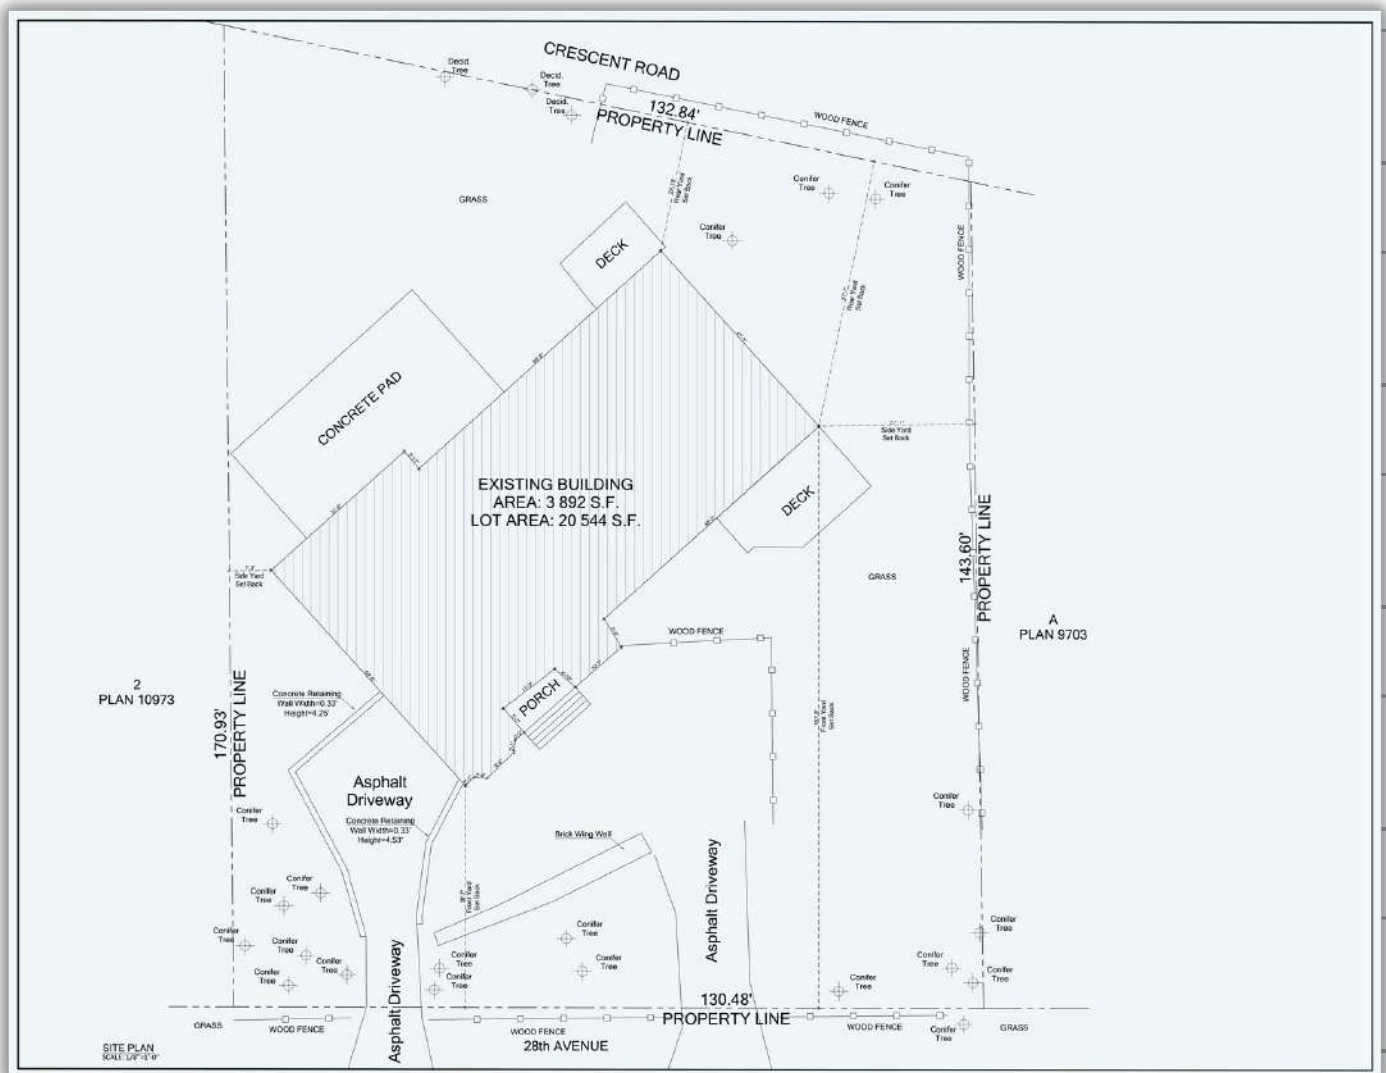


⑤ EXISTING FLOOR PLAN

\*\* We use LiDAR laser scanning, ensuring precise outdoor features

# CROSS SECTIONS

(ADDS ON)

- Precise cut-throughs that provide structural clarity, ensuring builders and contractors understand ceiling heights, materials, and construction details without guesswork.

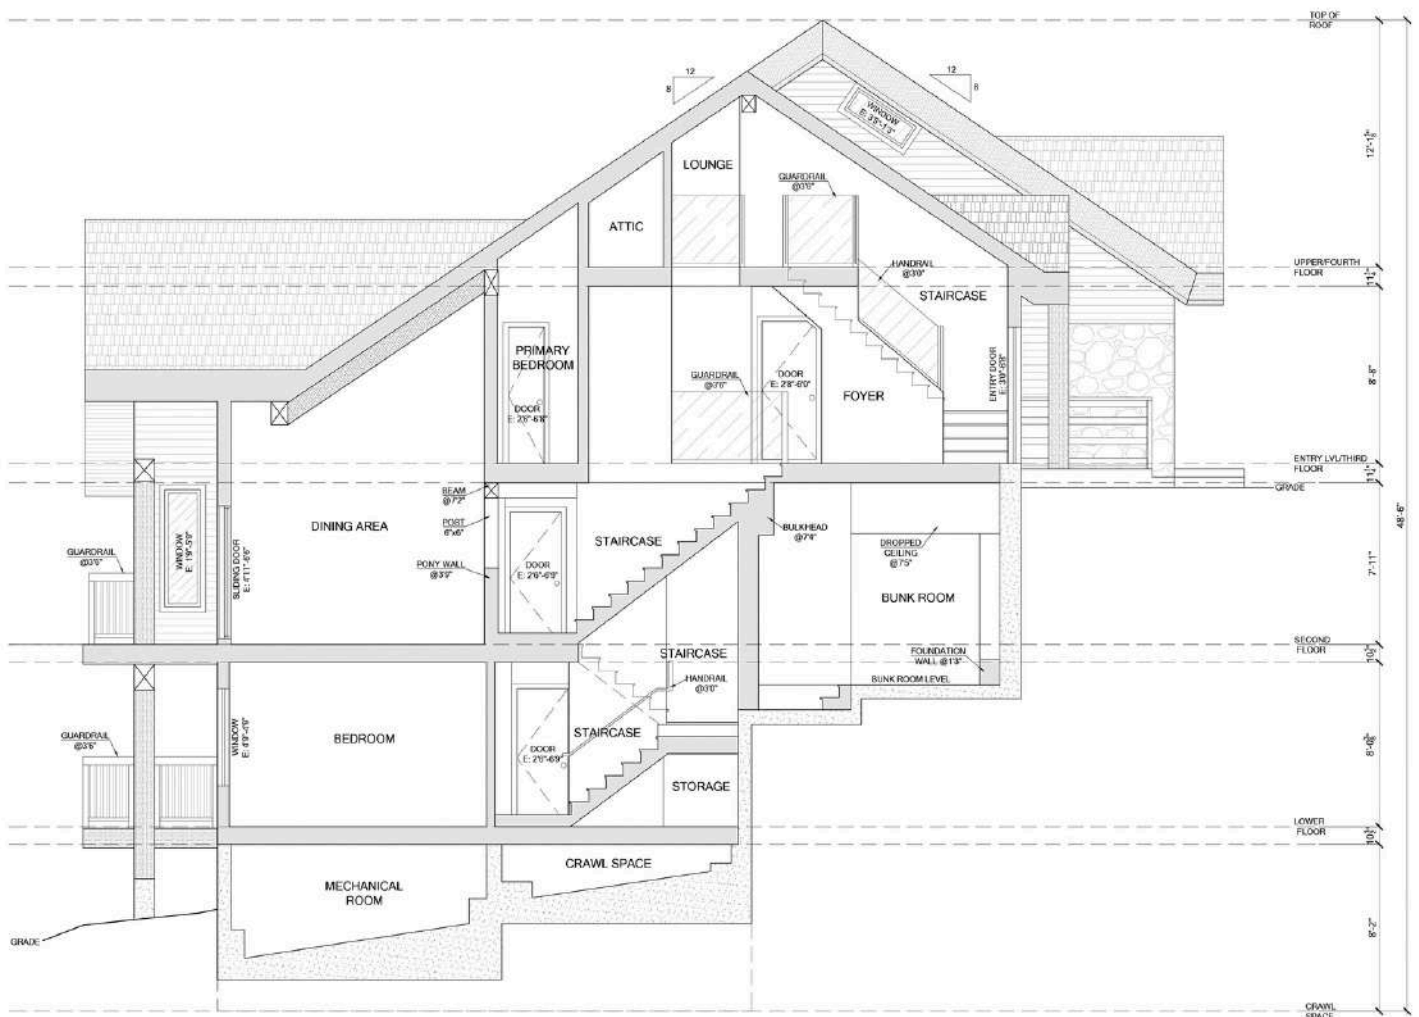


⑥ CROSS SECTION S1-A6  
SCALE: 1/4"=1'-0"


# INTERIOR ELEVATIONS

(ADDS ON)

- Detailed representations of interior spaces, accurately capturing built-ins, wall finishes, and materials, helping designers work on the project with precision and efficiency.

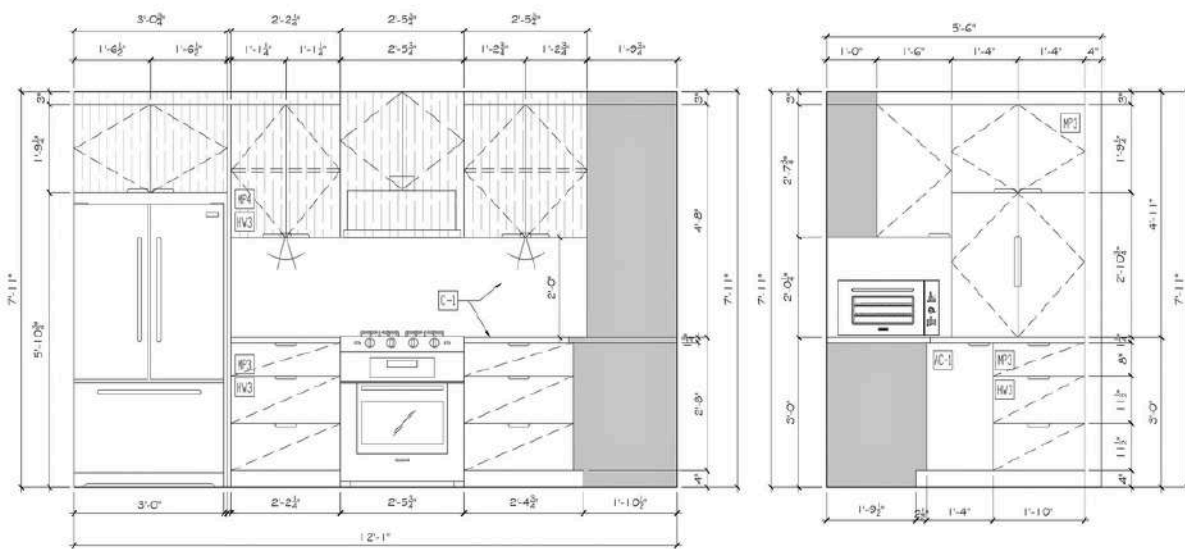

⑦ 1-2  
D-6.1 KITCHEN ELEVATION  
SCALE: 1/2"=1'-0"

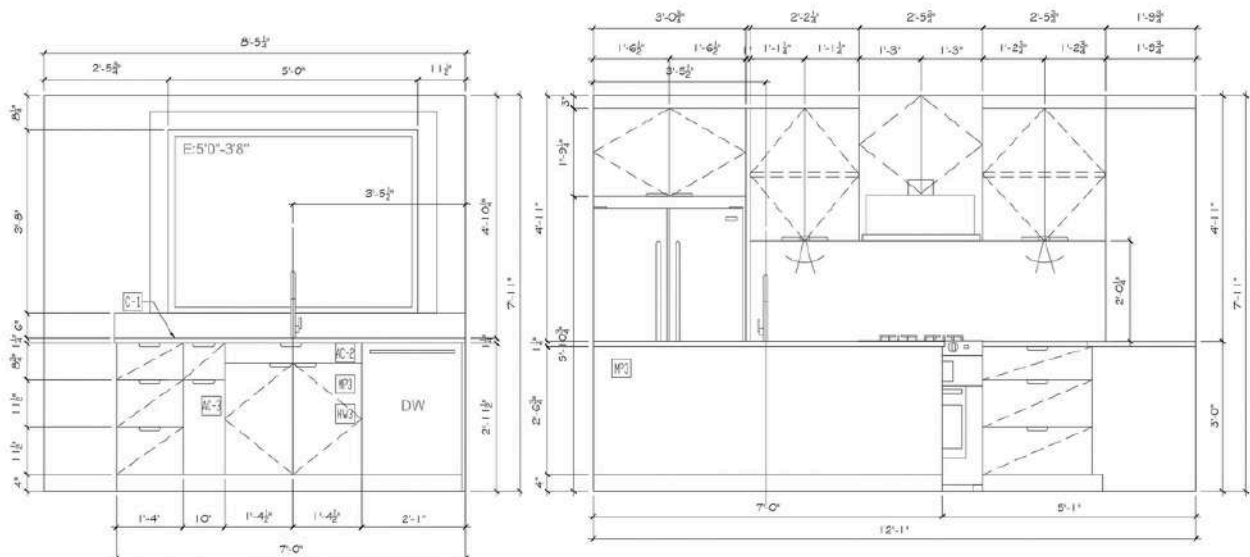

⑧ 3-4  
D-6.1 KITCHEN ELEVATION  
SCALE: 1/2"=1'-0"


# LIDAR SCANS

(ADDS ON)

- Advanced 3D scanning technology minimizes human error and speeds up the drafting process, providing highly accurate as-built measurements for complex projects



9 LIDAR SCAN

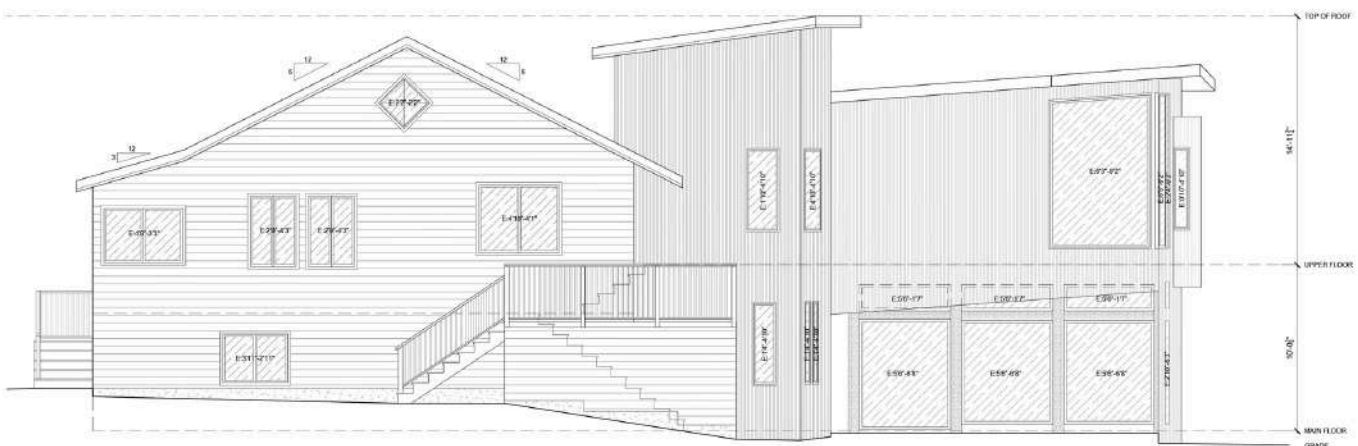

10 EAST ELEVATION  
SCALE: 1/4"=1'-0"

# Scope of Work – Services for Interior Designers

- ✓ As-built Floor Plans
- ✓ Exterior Elevations
- ✓ Reflected Ceiling Plan (RCP)
- ✓ Site Plan (adds on)
- ✓ Cross-Sections (adds on)
- ✓ Interior Elevations (adds on)
- ✓ LiDAR Scanning (adds on)

## You Can Rely on Us For:

- ✓ Fast turnaround times to keep projects moving
- ✓ Rigorous quality control to ensure precise, error-free drawings before delivery

**Precision. Accuracy.**

Your foundation for inspired interior design





When details matter, precision makes all the difference.


Our goal is to empower interior designers with reliable plans that make design execution seamless.



Reach out today to discuss your project!

 [info@measurebuilt.com](mailto:info@measurebuilt.com)

 (236) 988-8488

 [measurebuilt.com](https://www.measurebuilt.com)

